



04/05/93	SUBMITTED FOR OWNER/TENANT APPROVAL
04/05/93	SUBMITTED FOR BUILDING PERMIT
04/16/93	SUBMITTED FOR BID
04/17/93	OWNER/TENANT/BID CORRECTIONS
05-17-93	BUILDING PERMIT CORRECTIONS
05-17-93	CONSTRUCTION DRAWINGS
AS-BUILT	DRAWINGS

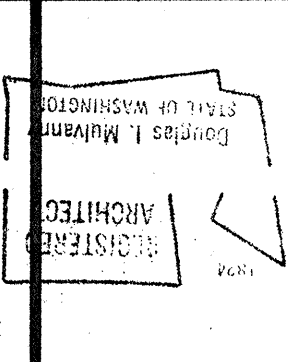

- NOTES**
1. DIMENSIONS SHOWN TO BE COORDINATED & VERIFIED UPON FINAL BUILDING PERMIT PRIOR TO CONSTRUCTION.
 2. ALL MECH. UNITS TO BE COORDINATED & VERIFIED W/ METAL ROOF SUPPLIER PRIOR TO CONSTRUCTION.
 3. SEE MECH. DWGS. FOR EXACT LOCATIONS OF ALL MECH. UNITS, ALL MECH. UNIT CURBS BY THIS.
 4. SUBMIT SPRINKLER SHOP DWGS. TO ARCH. W/ THESE DRAWINGS FOR REVIEW PRIOR TO INSTALLATION.
 5. CONTRACTOR TO LOCATE BURSULAR BARS & STAKE MANAGER.
 6. SMOKE VENTING IS PROVIDED AT 1 SQ. FT. VENT / 100 SQ. FT. AREA TO BE VENTED. ALSO 7.5% FREE AREA IS 144 SQ. FT. 23 SMOKE VENTS REQ'D. 24 SMOKE PROVIDED.

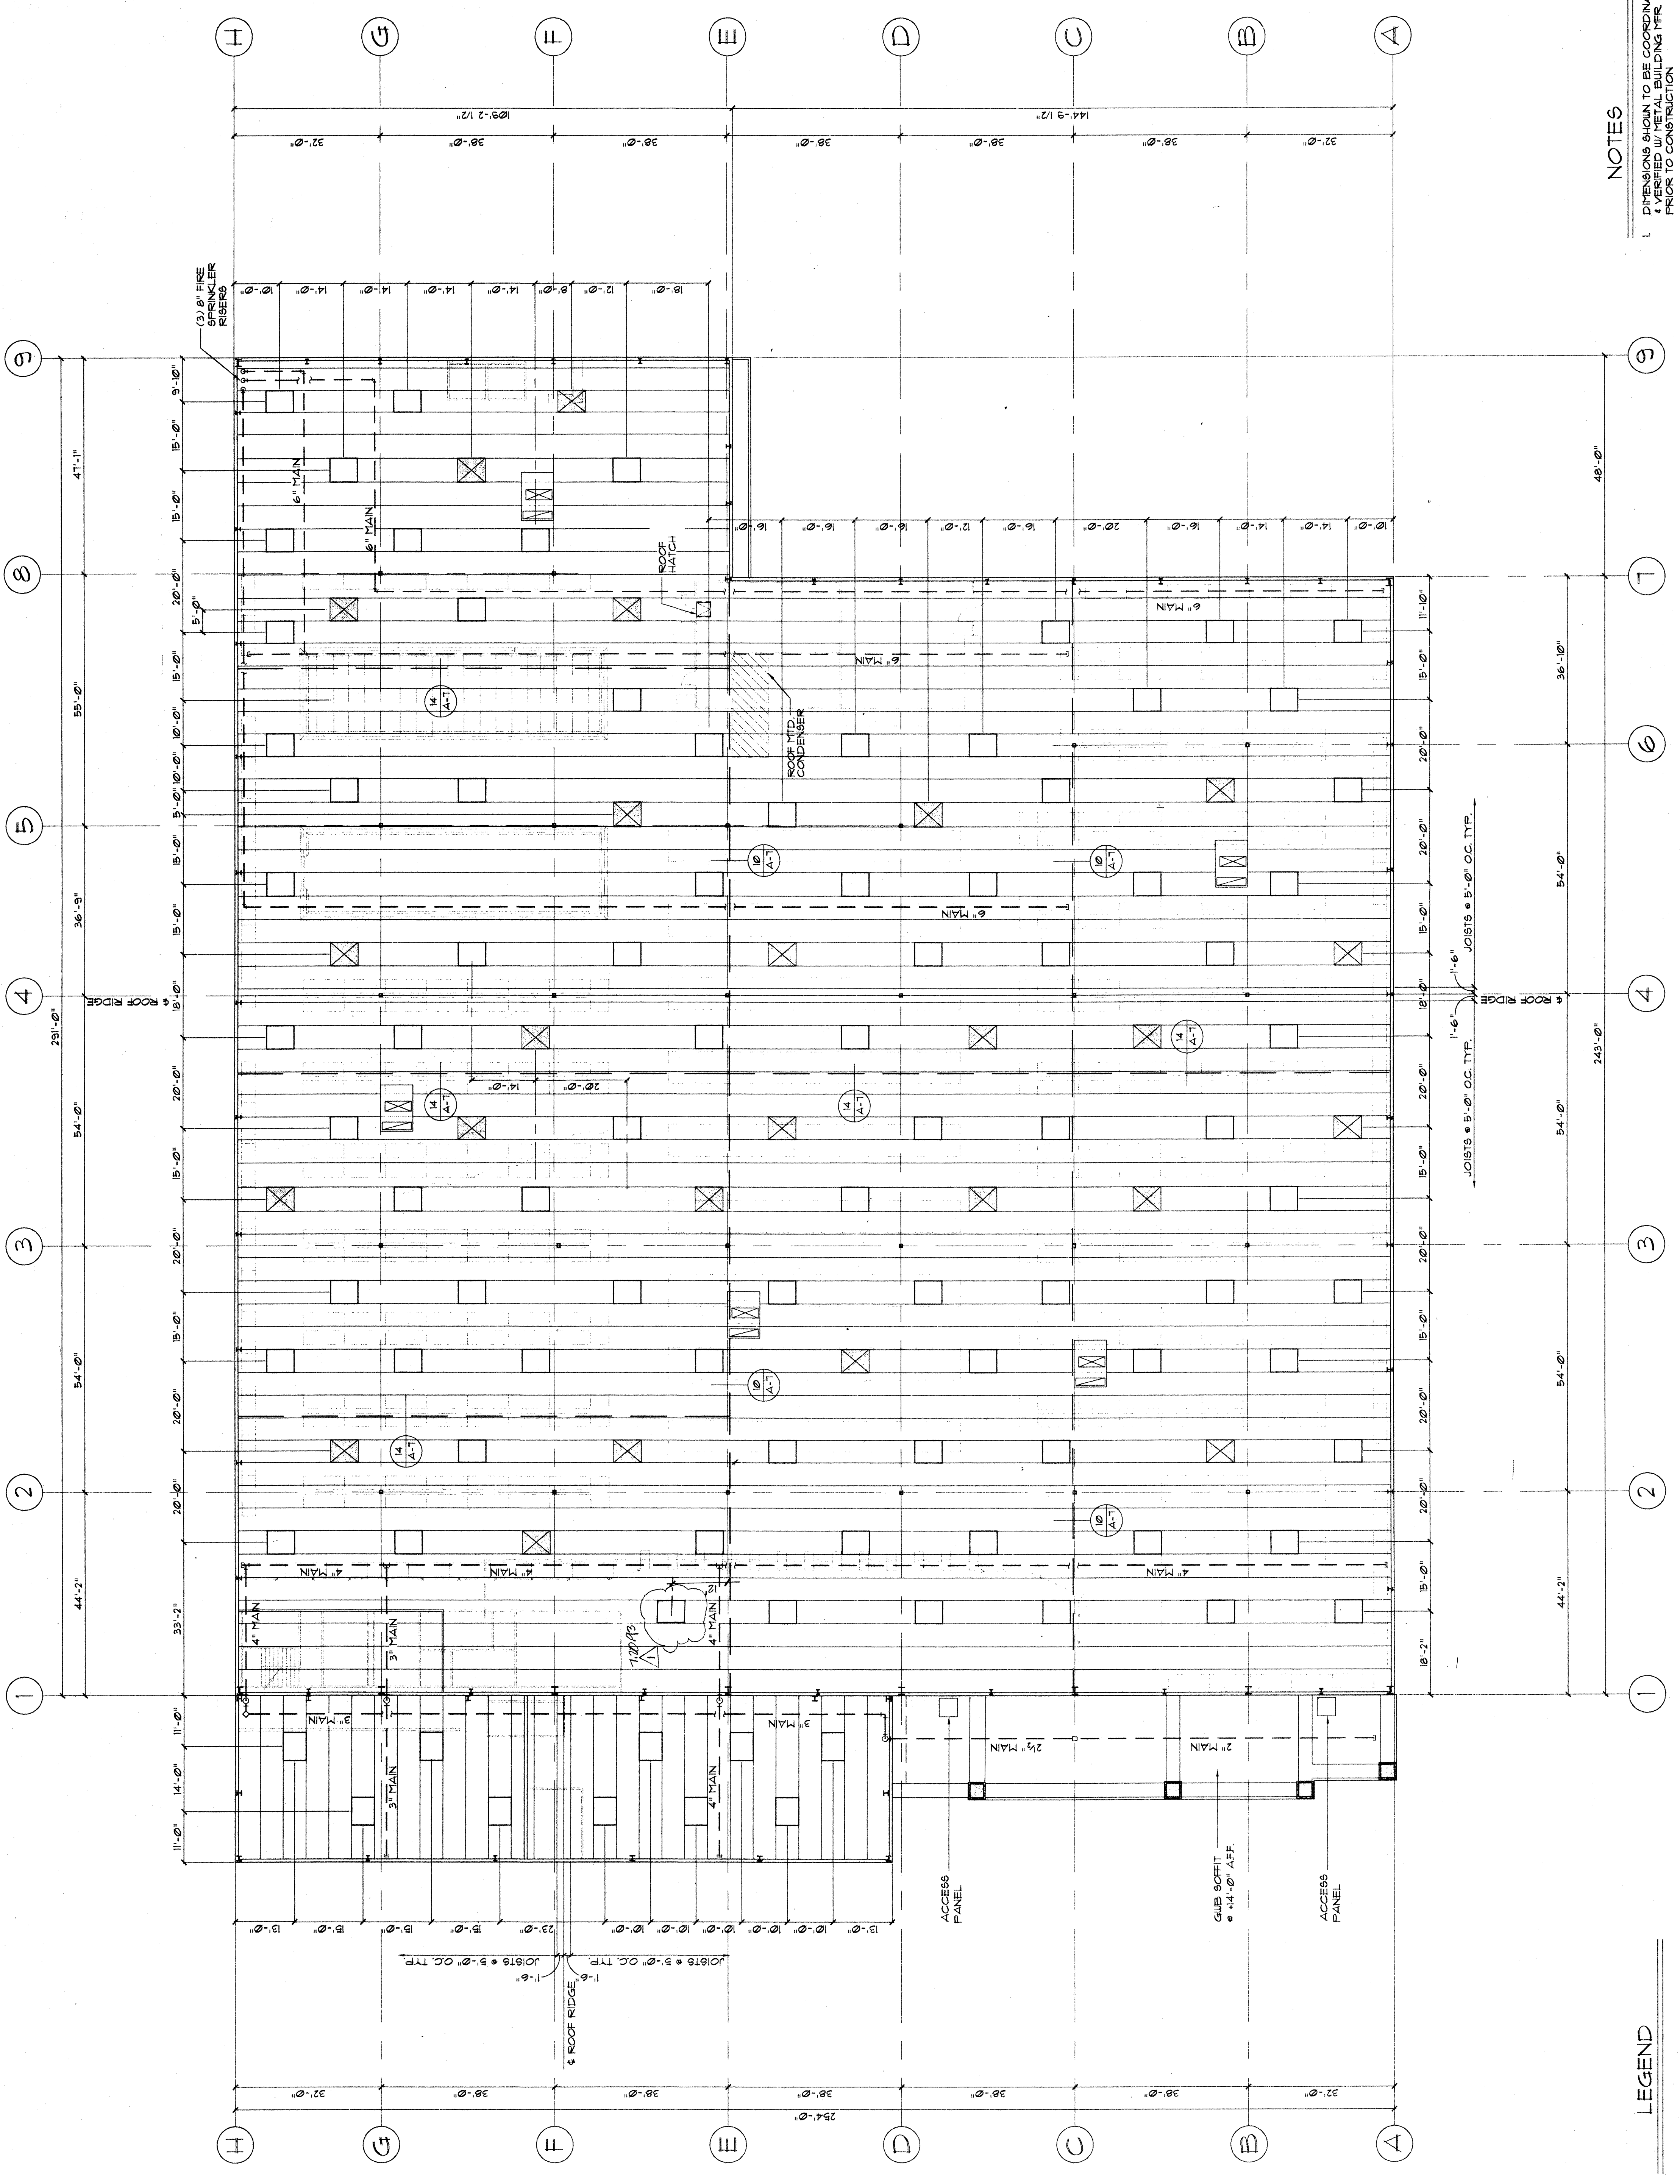

- LEGEND**
- 5' x 6' SKYLIGHT W/ DEL. DOME ON INSUL. CURB ASSEMBLY
 - 5' x 6' SMOKE VENT W/ SINGLE DOME
 - CONDENSER EQUIP. SPRINKLER MANS. REFRIG. DRAWINGS
 - HVAC. PER MECH. DWGS.
 - CURTAIN BOARD
 - SPRINKLER MANS (SIZE PER PLAN)

SKYLIGHT PLAN
SCALE: 1/8" = 1'-0"

